


Preliminary - Not for Construction Purposes

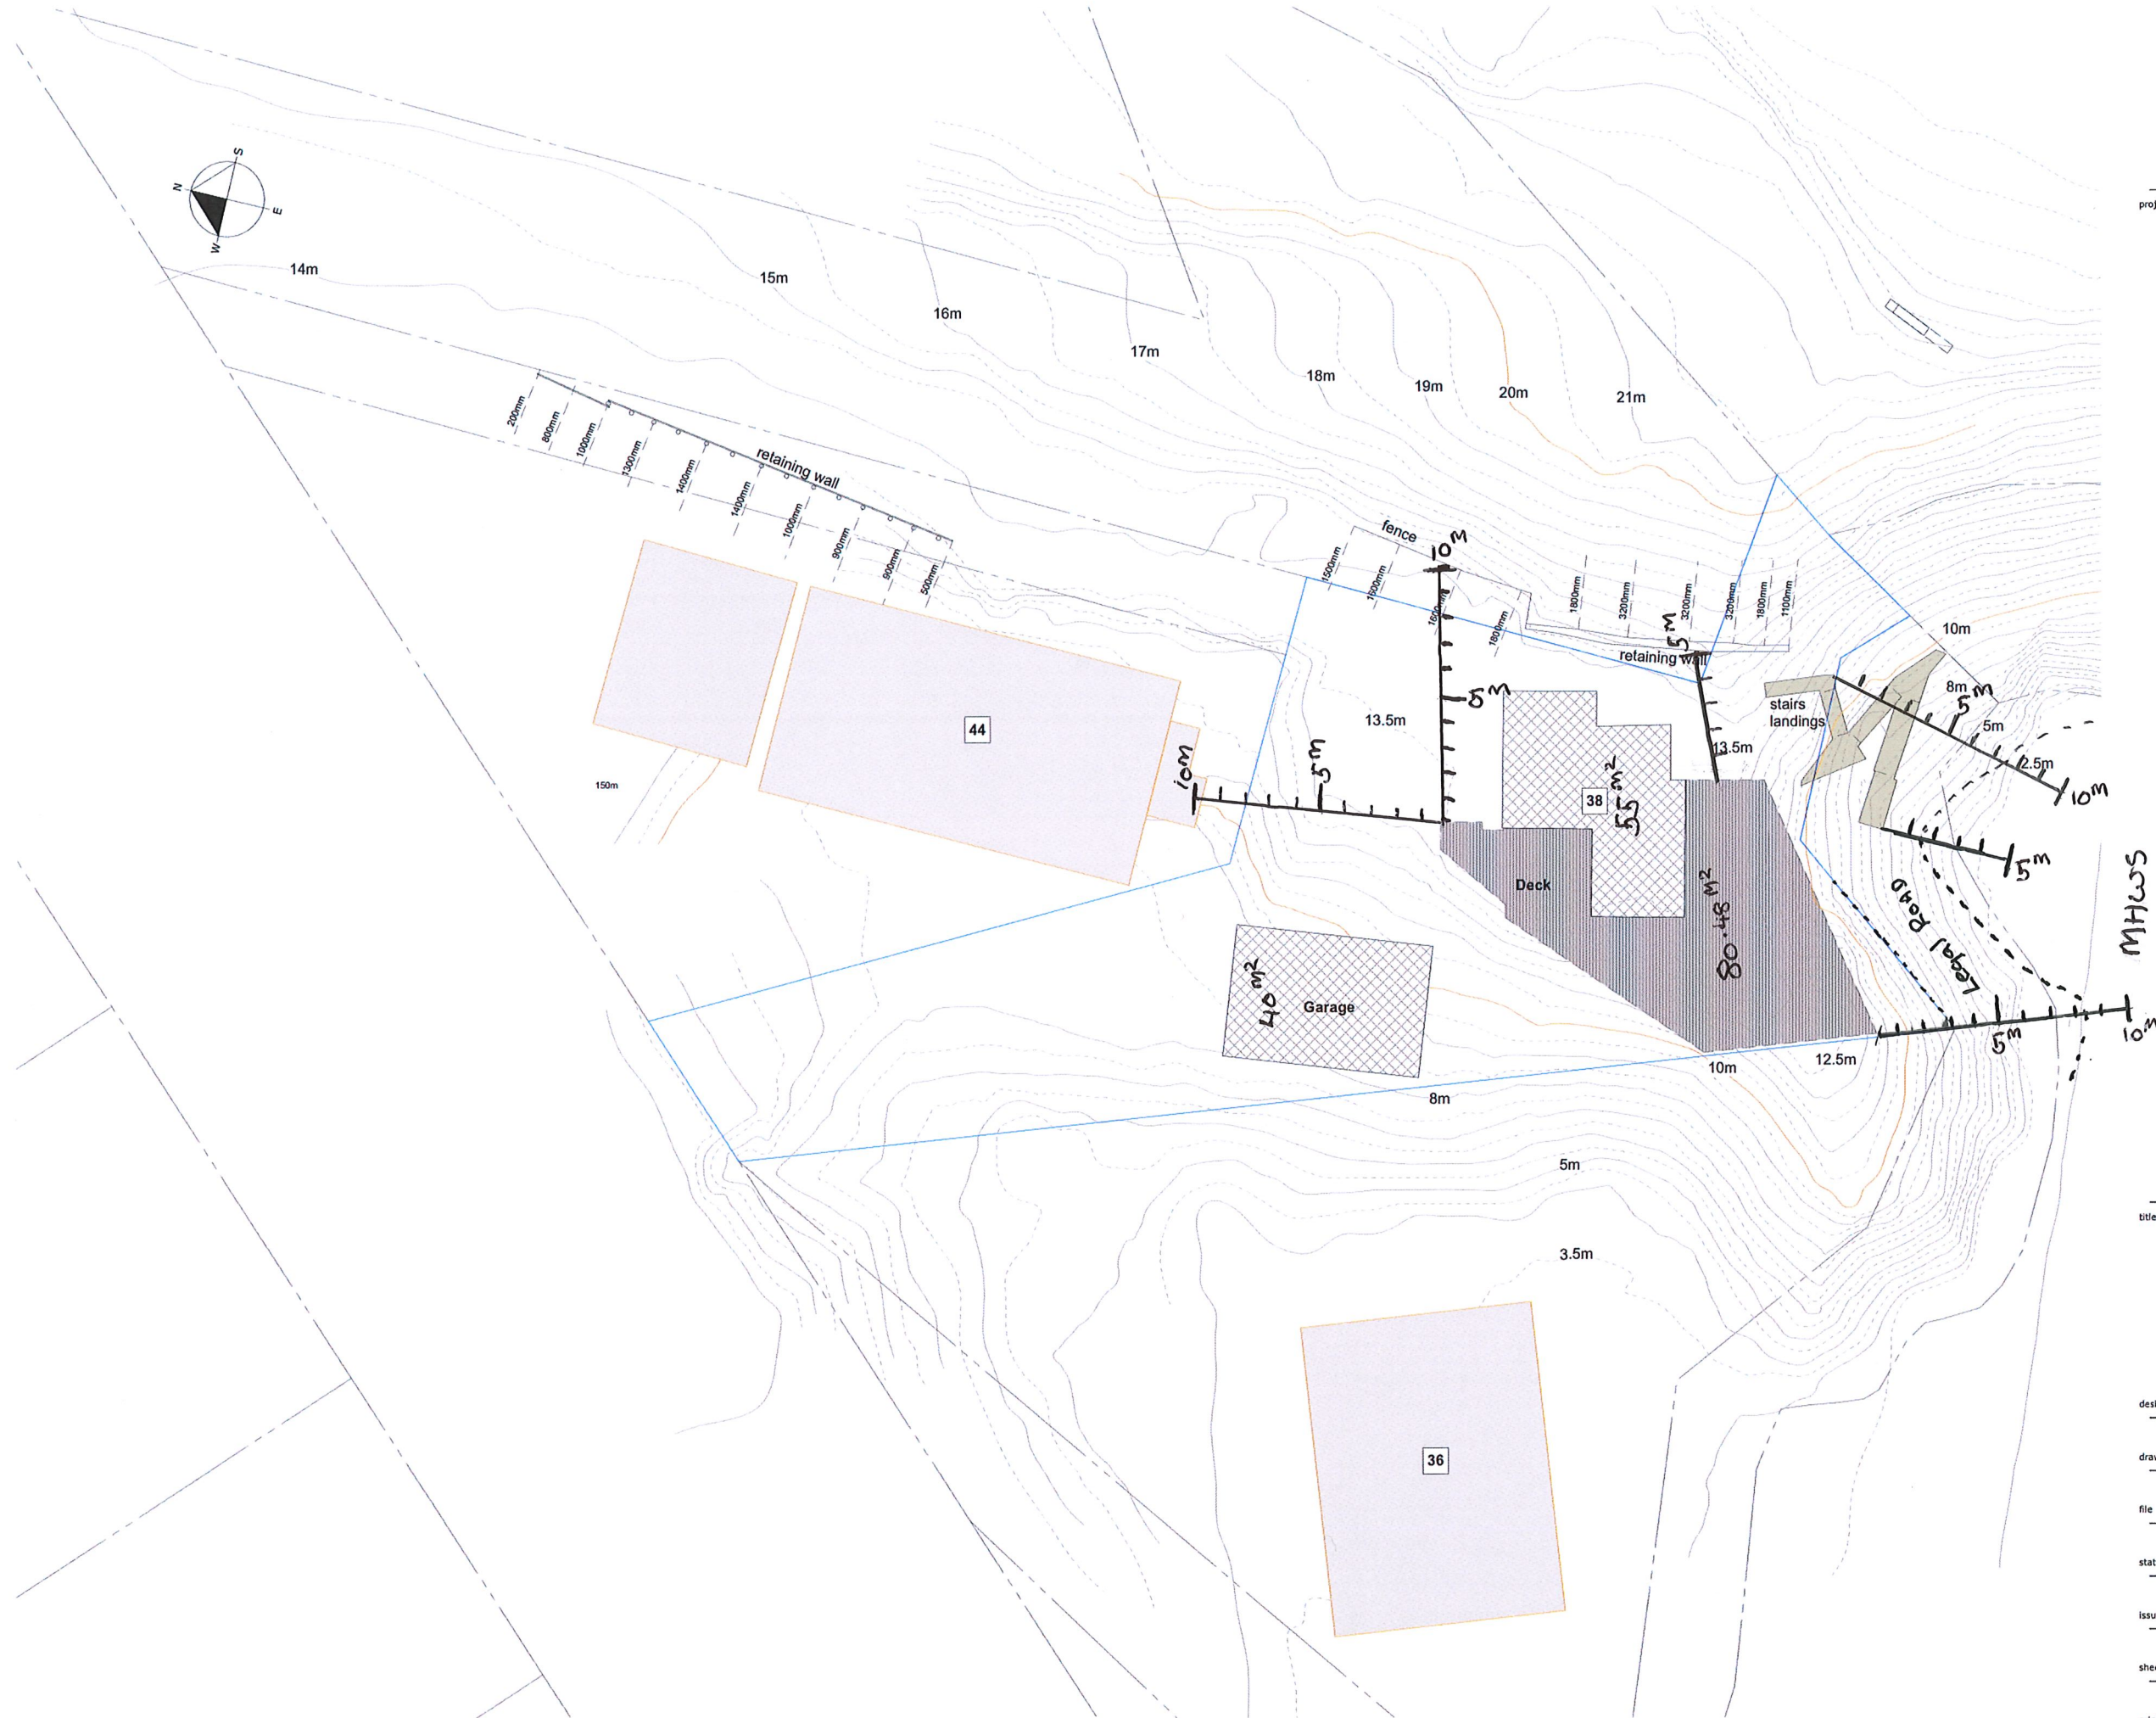

Site Plan
Scale 1:200

project	David Tipple Deck - As built 38 Kaiteriteri Sandy Bay Road Kaiteriteri
title	Site Plan
design	#Contact Full Name
drawn	TOG
file	2022 Tipple
status	Preliminary
issue	A
sheet	A101
printed	5/09/2022
print size	A2

This drawing is copyright. Under no circumstances may this drawing be reproduced in any form without the written permission