


**Western Elevation**  
 Scale 1:100

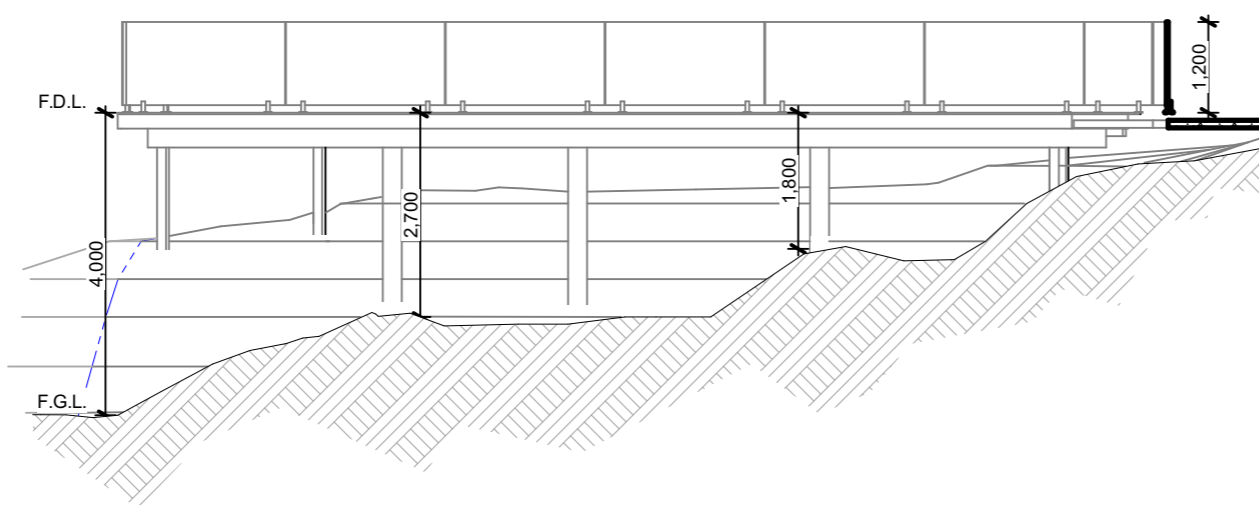

**Southern Elevation**  
 Scale 1:100

project

**David Tipple**  
 Deck - As built  
 38 Kaiteriteri Sandy Bay Road  
 Kaiteriteri

title

**Southern and Western Elevation**

design

drawn **TOG**

file **2022 Tipple**

status **Resource Consent**

issue **A**

sheet **A111**

printed **20/02/2024** print size **A3**

This drawing is copyright. Under no circumstances may this drawing be reproduced in any form without the written permission